
NOTES:
1. PRESSURE TRANSDUCER RANGE FOR COOLING TOWER SIDE SYSTEM : 0–150 PSI.
2. PRESSURE TRANSDUCER RANGE FOR PROCESS SIDE SYSTEM : 0–200 PSI.
3. PRESSURE TRANSDUCER RANGE FOR TANKS : 0–15 PSI.

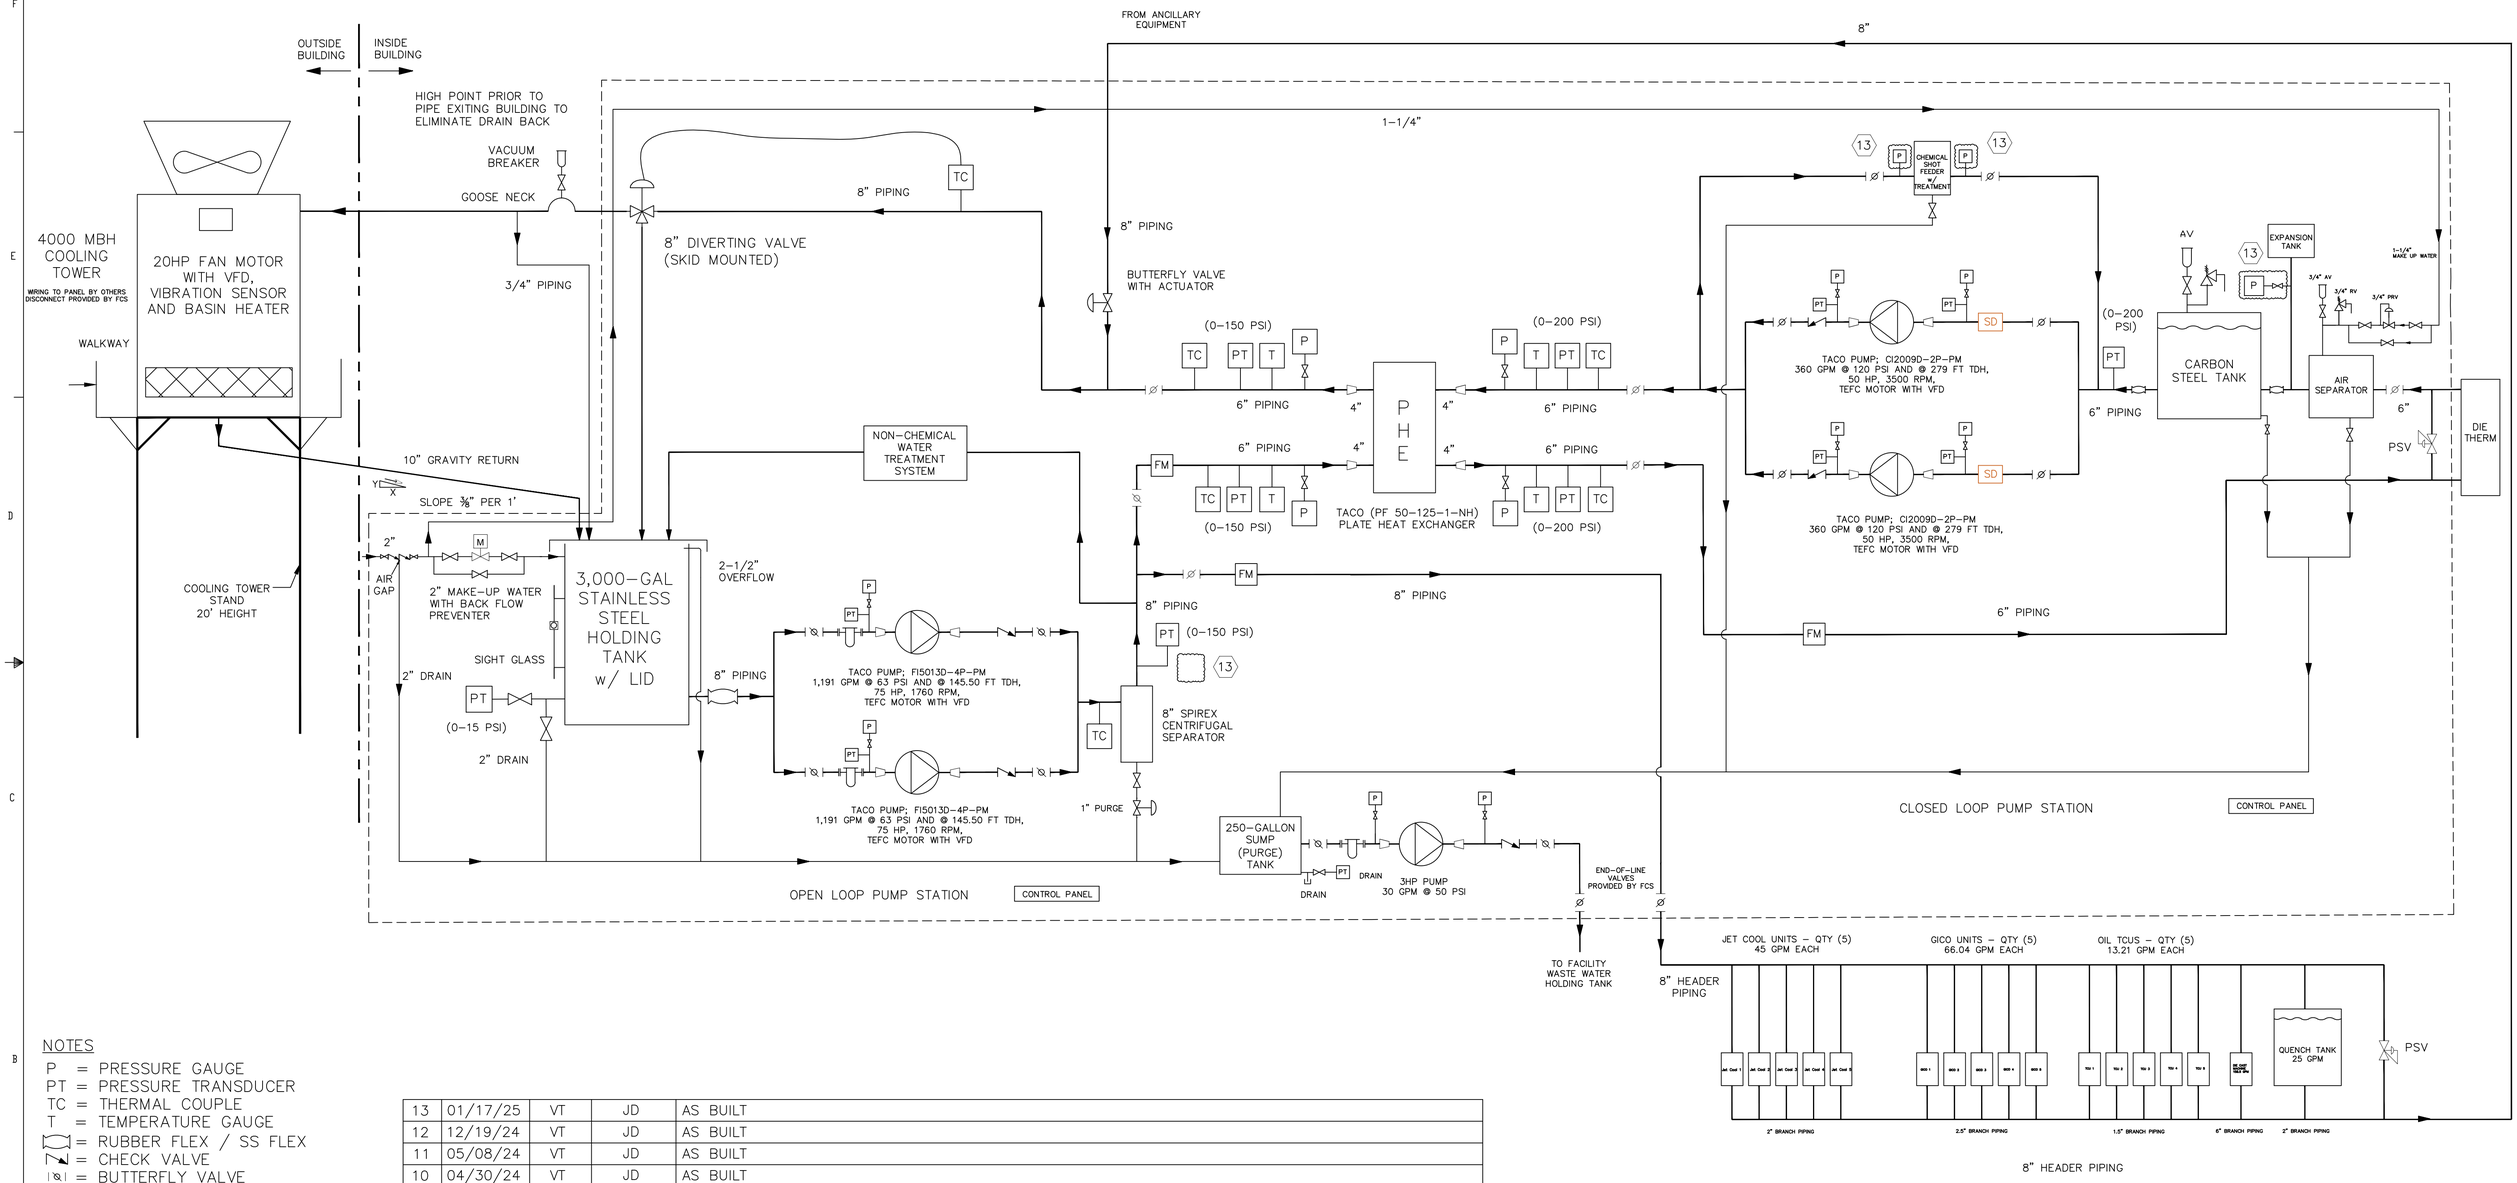

NOTES

P = PRESSURE GAUGE
PT = PRESSURE TRANSDUCER
TC = THERMAL COUPLE
T = TEMPERATURE GAUGE
= RUBBER FLEX / SS FLEX
= CHECK VALVE
= BUTTERFLY VALVE
= GATE / BALL VALVE
= PRESSURE RELIEF VALVE
= PRESSURE SUSTAINING / REDUCING VALVE
= BASKET STRAINER
= Y–STRAINER
= AUTO AIR VENT (AV)
= SUCTION DIFFUSER
= FLOW CONTROL VALVE
= DIVERTING VALVE / MIXING VALVE

REV	DATE	DESIGN	ENG CHK	DESCRIPTION
13	01/17/25	VT	JD	AS BUILT
12	12/19/24	VT	JD	AS BUILT
11	05/08/24	VT	JD	AS BUILT
10	04/30/24	VT	JD	AS BUILT
9	04/17/24	VT	JD	AS BUILT
8	03/16/24	VT	JD	PHE AND PROCESS PUMP MODEL IS UPDATED
7	03/01/24	VT	JD	REVISION IS INLINE WITH ORTHO DRAWINGS
6	02/15/24	VT	JD	REVISION IS INLINE WITH ORTHO DRAWINGS
5	02/05/24	VT	JD	CUSTOMER COMMENTS ARE INCORPORATED
4	02/01/24	VT	JD	CUSTOMER COMMENTS ARE INCORPORATED
3	01/25/24	VT	JD	CUSTOMER COMMENTS ARE INCORPORATED
2	01/11/24	VT	JD	CUSTOMER COMMENTS ARE INCORPORATED
1	01/04/24	VT	JD	MAKE–UP WATER LINE IS UPDATED TO 2" SIZE
0	10/27/23	JD	BA	APPROVAL

⬡ SYMBOL IDENTIFIES REVISION. REFER TO REV. BLOCK FOR DESCRIPTION OF CHANGE(S).

This drawing and data is the property of Fluid Cooling Systems, LLC. The information contained herein is confidential and proprietary information of Fluid Cooling Systems and is not transferable. This print is furnished with the clear understanding that it is to be used only for repair and maintenance of equipment furnished by Fluid Cooling System, LLC and to assist in obtaining spare parts. It shall not be loaned, copied, or otherwise used in manufacture without the express written permission of Fluid Cooling Systems, LLC.

FLUID COOLING SYSTEMS, LLC.
2441 E. Bristol Rd
Burton, MI. 48529
☐: 248.430.6271
www.fluidcoolingsystems.com

DRAWING TITLE: PROCESS & INSTRUMENTATION DIAGRAM (P&ID)
EQUIPMENT: 230384 GALA–FORD TDM
SHEET NO.: 1 OF 1
REV.: 13
CUSTOMER:
DRAWING NO.: 230384_PID